


1- #2 THWN GREEN
GROUND WIRE

ANODE
1

AS BUILT



NO.	DATE	BY	REVISION
2	12/10/10	GB	MOVED ANODE LOCATION
1	10/26/10	GB	AS BUILT

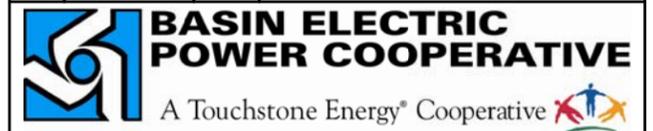

GAS PIPELINE PLANT SITE
GROUNDING, DEER CREEK STATION

SCALE	DATE	DRAWN BY	APPROVED BY
3/16"=1'	6/2/10	CASSIE PETER	DAVE YEXLEY

DCS-EG-ONG-0001

NOTE: FENCE TO BE GROUNDED PER DETAILS BY OTHERS