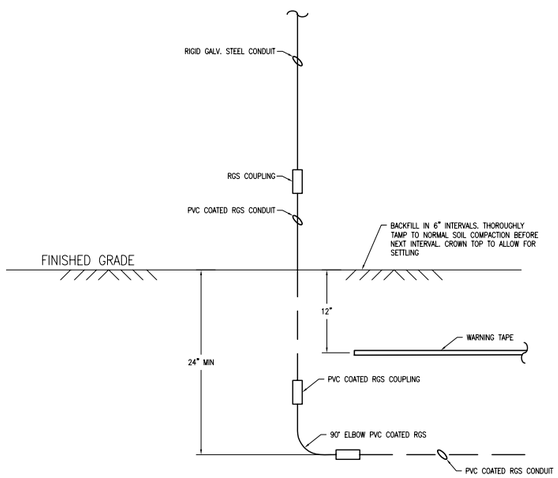

CONDUIT TRANSITION

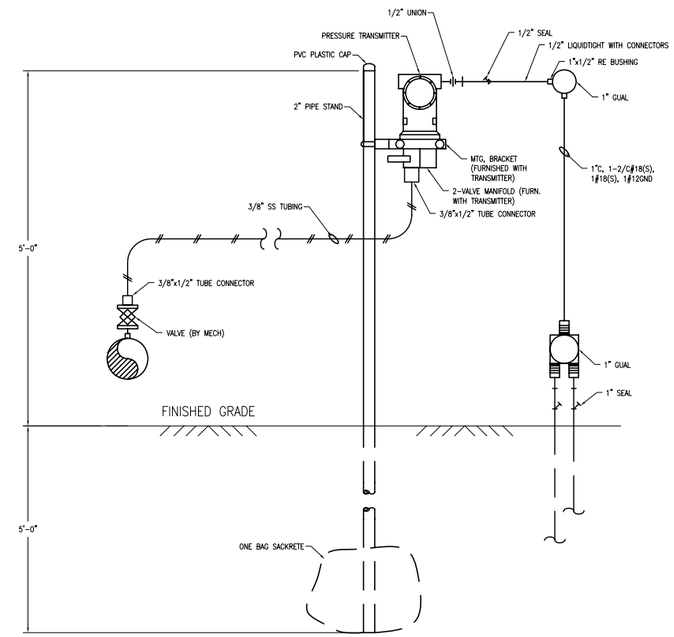

PRESSURE TRANSMITTER

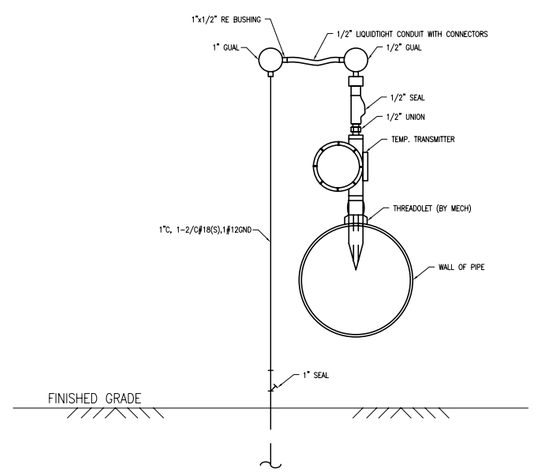

TEMPERATURE TRANSMITTER

AS BUILT

REGISTERED PROFESSIONAL ENGINEER
REG NO. 9918
DAVID P. YEXLEY
SOUTH DAKOTA

NO.	DATE	BY	REVISION
-	-	-	-

BASIN ELECTRIC POWER COOPERATIVE
A Touchstone Energy® Cooperative

MONTANA-DAKOTA UTILITIES CO.
A Division of MDU Resources Group, Inc.

GAS PIPELINE PLANT SITE INSTRUMENTATION
DEER CREEK STATION

SCALE	DATE	DRAWN BY	APPROVED BY
NONE	6/2/10	CASSIE PETER	DAVE YEXLEY

DCS-IA-ONG-0001